

UNIVERSITY OF MIAMI  
ROSENSTIEL  
SCHOOL of MARINE &  
ATMOSPHERIC SCIENCE



Tritium Laboratory  
25 March 2013

Tritium Laboratory  
4600 Rickenbacker Causeway  
Miami, Florida 33149-1031

Ph: 305-421-4100  
Fax: 305-421-4112  
E-mail: Tritium@rsmas.miami.edu

SWAB REPORT # 671

SWAB DATE: 20 March 2013

*R/V Atlantic Explorer* and UNOLS Van #2409.01

---

Dr. James D. Happell  
Associate Research Professor

Distribution:  
SWAB Committee  
James Caison

## COMMENTS TO SWAB REPORTS

23 November 2010

Typical LSC instrument background values for  $^3\text{H}$  and  $^{14}\text{C}$  are 2 and 5 cpm, respectively. The LSC is a Tricarb 2910 TR with the low level counting option.

All samples are counted for 60 minutes, the instrument background is subtracted, and activities are reported in  $\text{dpm}/\text{m}^2$ . Bucket blank activities are not subtracted. Counting errors (2 standard deviations) are also reported in  $\text{dpm}/\text{m}^2$ . An error larger than the activity indicates that the activity is not significantly different from zero.

### Criteria for SWAB Results

Category	$^3\text{H}$ ( $\text{dpm}/\text{m}^2$ )	$^{14}\text{C}$ ( $\text{dpm m}^2$ )	Recommendations
A	<500	<50	No action
B*	500-10,000	50-10,000	Needs cleaning before any natural tracer work. Decks in radiation vans with activities above 1000 $\text{dpm}/\text{m}^2$ should be cleaned.
C**	10,000-100,000	10,000-50,000	Must be cleaned before any use.
D***	>100,000	>50,000	May be a health hazard. Notify local radiation safety official.

Note:  $^{14}\text{C}$  and  $^{35}\text{S}$  have peak energies of 156 and 167 KeV, respectively; thus  $^{35}\text{S}$  will be registered as  $^{14}\text{C}$  by our counting techniques. Categories A, B and C are not a health hazard.

### Recommended Cleaning Procedure

Wearing ordinary household rubber gloves:

$^3\text{H}$ : Wash and scrub with radioactive cleanup detergent such as COUNT-OFF (50 ml COUNT-OFF to 4 liters of water), using sponges to distribute solution and reabsorb it.

$^{14}\text{C}$ : Wash with 1% sulfuric or 2% hydrochloric (muriatic) acid with good ventilation (will dissolve carbonates, releasing  $^{14}\text{CO}_2$ ). Follow up with wash as if for  $^3\text{H}$ .

### Disposal of Cleaning Materials (gloves, sponges, etc)

Categories A & B dispose as ordinary garbage, C & D dispose in radiation waste system.

Note: If category C or D is encountered, we try to notify the insitution promptly by phone or email.

REPORT FOR SWAB # 671

LOCATION: St. George, Bermuda  
VESSEL: *R/V Atlantic Explorer*

DATE: 20 March 2013  
TECHNICIAN: Cecilia Roig

Sample #	Sample Identification	<sup>3</sup> H dpm/m <sup>2</sup>		<sup>14</sup> C dpm/m <sup>2</sup>	
		activity	error	activity	error
1	1st Vial Bkgnd	0	± 0	0	± 0
2	Initial bucket blank	19	± 69	0	± 0
	<u>Aft/Wet Lab (Figure 1)</u>				
3	Inside fume hood	0	± 0	0	± 0
4	Deck at entrance to hood room	2	± 0	0	± 0
5	Benchtop forward of sink	46	± 76	0	± 0
6	Inside Roper freezer top	19	± 39	8	± 32
7	Inside Roper fridge bottom	0	± 0	7	± 40
8	Inside GE freezer	4	± 0	0	± 0
9	Inside small black GE	0	± 0	0	± 0
10	Center benchtop	21	± 107	0	± 0
11	Deck at forward entrance	0	± 0	12	± 38
12	Forward benchtop	25	± 63	0	± 0
	<u>Forward Lab (Figure 1)</u>				
13	Benchtop forward fo sink	0	± 0	0	± 0
14	Forward benchtop	0	± 0	7	± 40
15	Deck at starboard entrance	6	± 29	7	± 34
16	Deck at infirmary entrance	2	± 0	0	± 0
17	Deck at top of stairs	0	± 0	27	± 38
18	Inside VWR freezer	4	± 0	0	± 0
19	Deck under center benchtop	0	± 0	7	± 36
20	Benchtop aft of sink	0	± 0	0	± 0
21	Deck in Enviro Room	59	± 50	5	± 21
22	Benchtop inside Enviro Room	3	± 0	0	± 0
	<u>Main Lab (Figure 1)</u>				
23	Starboard forward freezer	26	± 44	5	± 28
24	Port forward freezer	0	± 0	0	± 0
25	Starboard benchtop	0	± 0	4	± 37
26	Deck in front of port benchtop	35	± 56	0	± 0
27	Deck in front of freezers	12	± 85	0	± 0
28	Deck in front of starboard benchtop	0	± 0	0	± 0
29	Deck inside aft entrance	19	± 55	0	± 0

Sample #	Sample Identification	<sup>3</sup> H dpm/m <sup>2</sup>		<sup>14</sup> C dpm/m <sup>2</sup>	
		activity	error	activity	error
30	Center benchtop	11	± 103	0	± 0
31	Benchtop aft of sink	0	± 0	0	± 0
32	Sink area	0	± 0	0	± 0
33	Inside clean air bench	8	± 0	0	± 0
34	Intermediate bucket blank	22	± 76	0	± 0
<u>UNOLS Shared Use Van 2409.01 (Figure 2)</u>					
35	Sink area	249	± 66	11	± 17
36	Benchtop next to LSC	403	± 69	18	± 17
37	Inside fume hood	348	± 64	44	± 26
38	Top of LSC	249	± 60	32	± 26
39	Deck between LSC and hood	*626	± 81	38	± 20
40	Deck at entrance	173	± 57	5	± 13
41	Forward benchtop	92	± 52	0	± 0
42	Inside Danby under sink	**15,014	± 347	*9,315	± 164
43	Final bucket blank	18	± 79	0	± 0


### Comments

Please note that the error reported for each isotope is the two-standard deviation counting error. All areas tested in the ship were free from <sup>3</sup>H or <sup>14</sup>C contamination that requires cleaning. Minor to moderate <sup>3</sup>H and minor <sup>14</sup>C contamination found in the van. The inside of the Danby refrigerator needs to be cleaned before any further use.

SWAB #671

Figure 1

20 March 2013

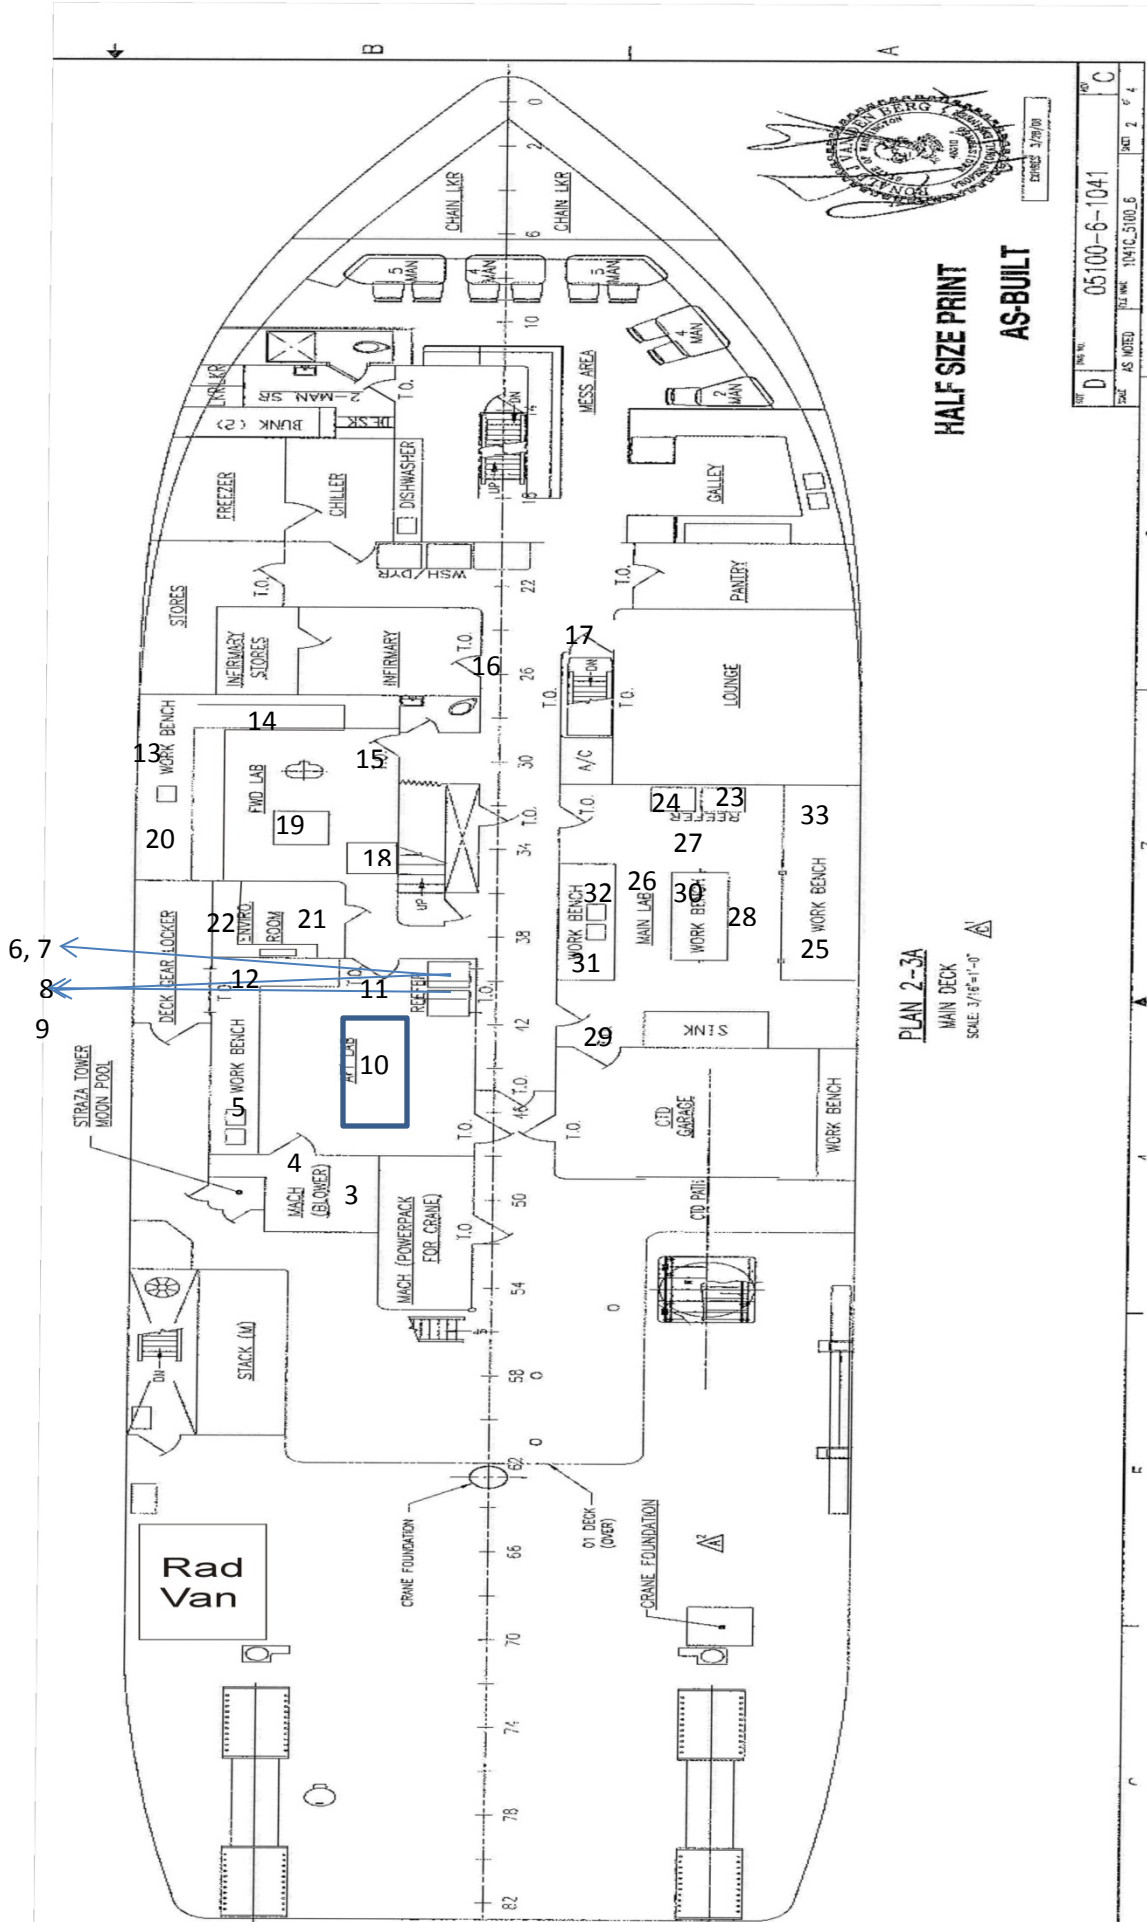

HALF SIZE PRINT  
AS-BUILT

PLAN 2-3A  
MAIN DECK  
SCALE 3/16"=1'-0"

REV	NO.	DATE	BY	CHKD
D	AS BUILT	05100-6-1041		

SWAB #671

Figure 2

20 March 2013

